No.	O.N.	Revision Description
1	250718	AMEND LOT AREA FOR RTZ (11/21/25)DANJR

CITY OF MIAMI ePLAN SPACE

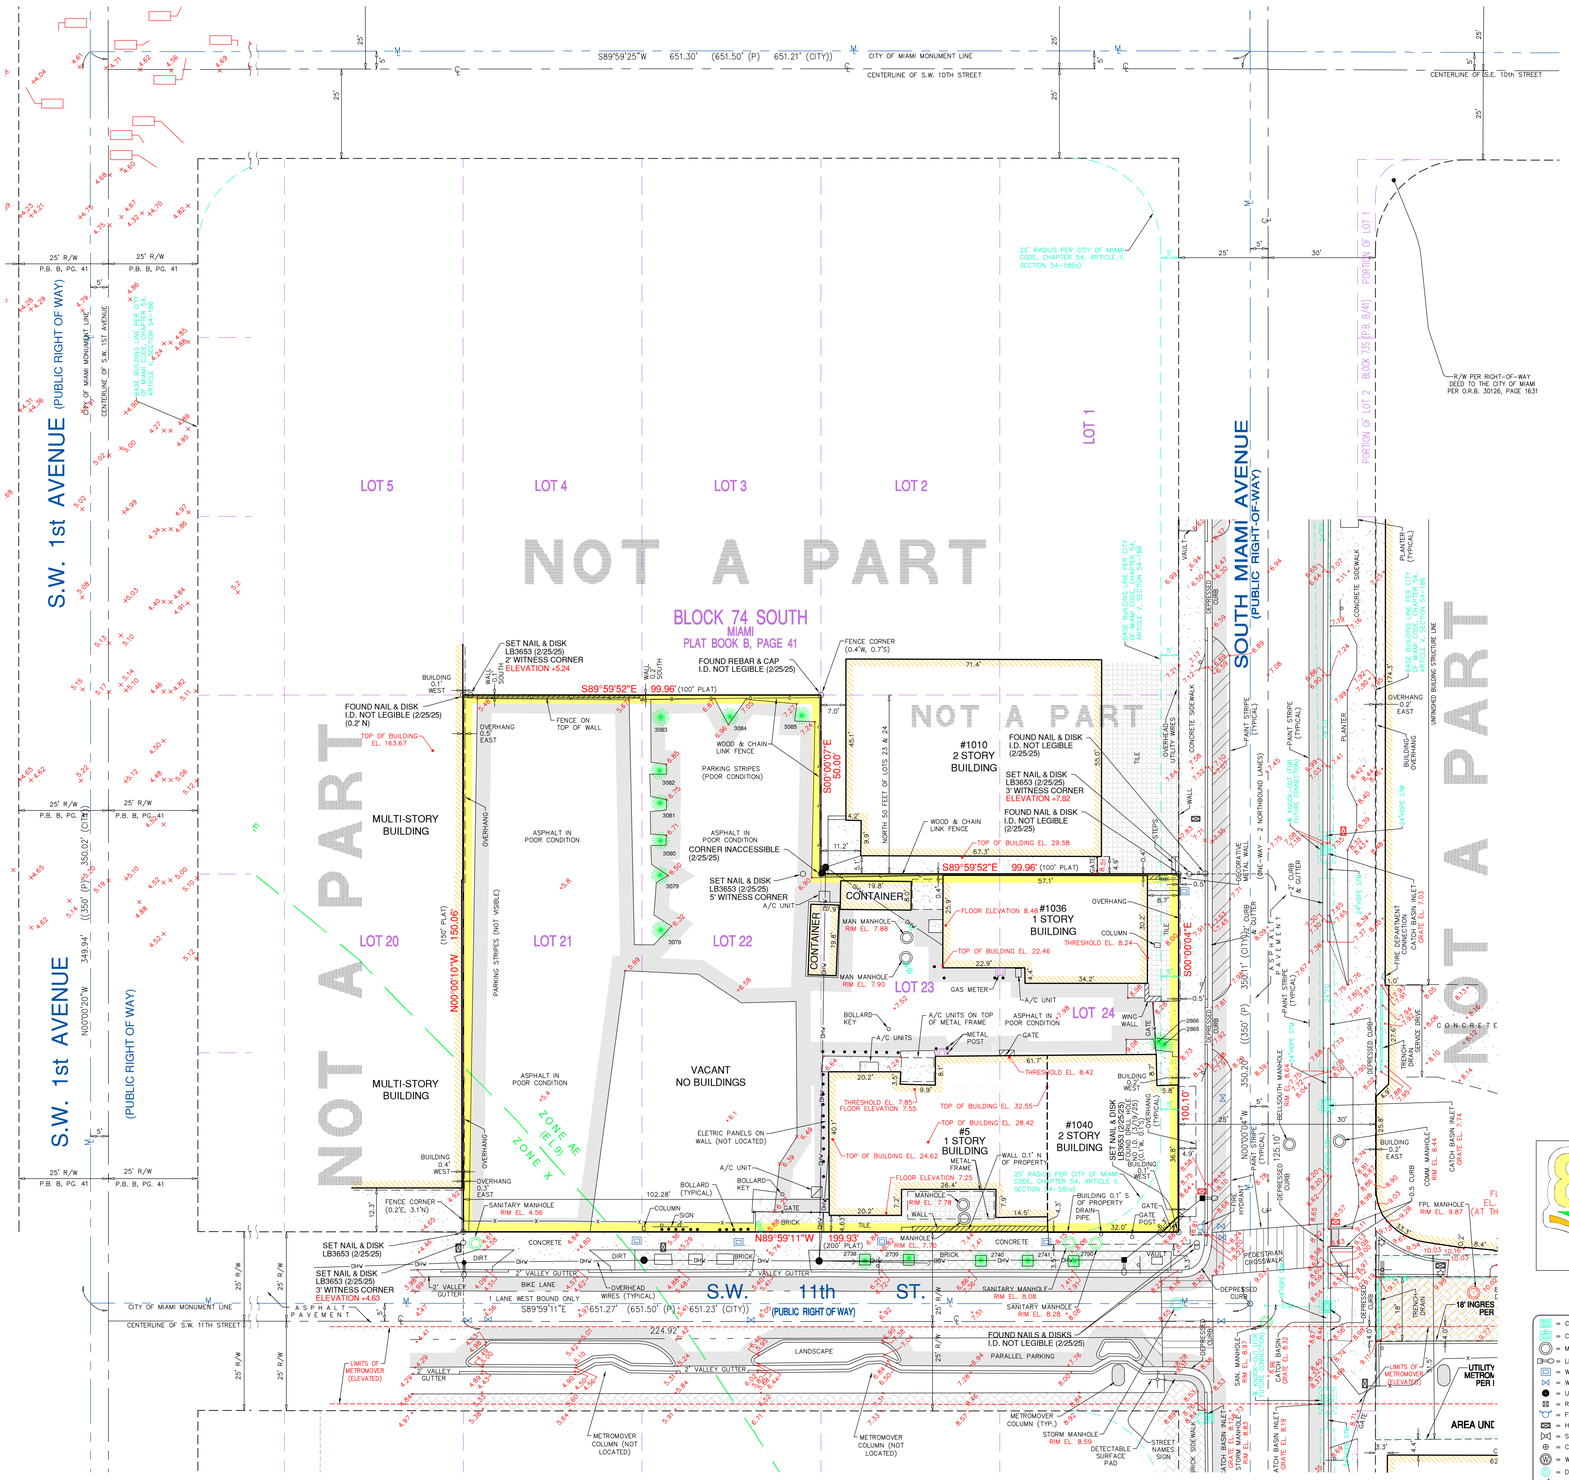

LOCATION SKETCH
NOT TO SCALE

GRAPHIC SCALE
0 10 20 40
(IN FEET)
1 inch = 20 ft.

LEGAL DESCRIPTION:

ALL OF LOTS 21, 22, & 23, LESS THE NORTH 50 FEET OF SAID LOTS 23 AND 24, ALL IN BLOCK 74S, OF "MIAMI", ACCORDING TO THE PLAT THEREOF, AS RECORDED IN PLAT BOOK B, AT PAGE 41, OF THE PUBLIC RECORDS OF MIAMI-DADE COUNTY, FLORIDA.

SURVEYOR'S NOTES:

- This site lies in Section 38, Township 54 South, Range 41 East, City of Miami, Miami-Dade County, Florida.
- All documents are recorded in the Public Records of Miami-Dade County, Florida, unless otherwise noted.
- Lands shown hereon were NOT abstracted for easements and/or rights-of-way of records.
- Bearings hereon are referred to an assumed value of S89°59'25"W for the South right-of-way line of S.W. 10th Street, and evidenced by set 1/2" pipe & cap and set nail & disk (being a witness corner set on a 10' offset). Not shown on this survey.
- Lands shown hereon are located within an area having a Zone Designation X & AE (EL 9) by the Federal Emergency Management Agency (FEMA), on Flood Insurance Rate Map No. 12086C0314L for Community No. 120650, dated September 11, 2009, and index map revised September 11, 2009, and is relative to the National Geodetic Vertical Datum of 1929.
- Dimensions indicated hereon are field measured by electronic measurement, unless otherwise noted.
- "Net Lot Area" containing 25,007 square feet, or 0.574 acres, more or less.
  "Net Lot Area" is defined as the area of lands as described in the legal description.
  "Gross Lot Area" containing 33,132 square feet, or 0.761 acres, more or less. 250718
  "Gross Lot Area" is defined as the area of lands per legal description plus the areas adjacent thereof to the centerline of S.W. 11th Street & South Miami Avenue.
- Elevations shown hereon are relative to the National Geodetic Vertical Datum of 1929 (N.G.V.D. 1929), based on City of Miami Bench Mark, Elevation +9.529 (N.G.V.D. 1929) (Stamped Elevation +9.789 (City of Miami Datum)), located on October 1, 2019, at the intersection of South Miami Avenue and S.W. 12th Street.
- Improvements shown beyond the scope/limits of this "Boundary & Topographic Survey" may not be current or located.
- All horizontal control measurements are within a precision of 1:10,000.
- This map is intended to be displayed at the graphic scale shown hereon or smaller.
- Per City of Miami Code under Chapter 54, Article II, Section 54-58(a):
  Right of way lines at street intersections shall be rounded with a radius of 25 feet, and the external areas shall be dedicated to the public for street purposes prior to the issuance of permits.
- Trees shown are surveyed for their horizontal location and/or size. Identification and/or name verification of all trees should be confirmed by the Division of Forestry, a certified Arborist or a professional in that field.
- The locations of overhead utility lines are graphically shown to indicate the approximate connection points and do not reflect the actual location, number or type of wires.
- Underground improvements and/or underground encroachments not shown unless otherwise indicated.
- The approximate location of all utilities shown hereon were determined from As-Built plans and/or on-site locations and should be verified before construction.
- Legal description shown hereon based on descriptions furnished by client and no claims as to ownership are made or implied.
- Tax Folio #: 01-0207-040-1270, per Miami-Dade County Property Appraiser's Website.

SURVEYOR'S CERTIFICATION

I hereby certify that this "Boundary and Topographic Survey" was made under my responsible charge on February 25, 2025, and meets the applicable codes as set forth in the Florida Administrative Code, pursuant to Section 472.027, Florida Statutes.

"Not valid without the signature and original raised seal or a digital signature of the Florida Licensed Surveyor and Mapper shown below"

FORTIN, LEAVY, SKILES, INC., LB3653

By: Daniel C. Fortin Jr. For The Firm
Surveyor and Mapper, LS6435
State of Florida.

Digitally signed by Daniel C Fortin
DN: c=US, o=Unaffiliated, dnQualifier=A01410C0000019A07A660C5000E2729, cn=Daniel C Fortin
Date: 2025.11.21 15:44:17 -05'00'

KNOW WHAT'S BELOW ALWAYS CALL 811 BEFORE YOU DIG
It's fast. It's free. It's the law.
www.sunshine811.com

LEGEND

- CATCH BASIN
- CATCH BASIN INLET
- MANHOLE
- LIGHT POLE
- WATER METER
- WATER VALVE
- UTILITY POLE
- RISER
- FIRE HYDRANT
- HANDHOLE
- SEWER/GAS VALVE
- CLEANOUT
- WELL
- DRAIN
- GRADE ELEVATION
- BOLLARD
- SIGN
- OHW = OVERHEAD UTILITY WIRE
- X = CHAIN LINK FENCE
- = LIMITED ACCESS RIGHT-OF-WAY LINE
- = 0.5' CURB
- = WALL
- = 2.00' CURB & GUTTER
- EL. = ELEVATION
- SAN. = SANITARY
- INV. = INVERT
- TYP. = TYPICAL
- C.L.F. = CHAIN LINK FENCE
- P.R.M. = PERMANENT REFERENCE MONUMENT
- C.O.M. ATLAS = CITY OF MIAMI ATLAS SHEET
- O.R.B. = OFFICIAL RECORDS BOOK
- P.B. = PLAT BOOK
- PG. = PAGE
- = CONCRETE
- = ASPHALT PAVEMENT
- R/W = RIGHT-OF-WAY
- = CENTER LINE
- = MONUMENT LINE
- P.O.B. = POINT OF BEGINNING

This Drawing is the Property of Fortin, Leavy, Skiles, Inc. and is an Instrument of Service not to be Reproduced in Whole or in Part without the Express WRITTEN Permission of Same.

FORTIN, LEAVY, SKILES, INC.
CONSULTING ENGINEERS, SURVEYORS & MAPPERS
FLORIDA CERTIFICATE OF AUTHORIZATION NUMBER: 00003653
180 N.E. 168th Street, North Miami Beach, Florida 33162
Phone: 305-653-4493 / Email: fls@flsurvey.com

BOUNDARY & TOPOGRAPHIC SURVEY
5 SW 11th STREET & 1036-1040 SOUTH MIAMI AVE.
CITY OF MIAMI, MIAMI-DADE COUNTY, FLORIDA

Original Date	2/25/25
Scale	1"=20'
Drawn By	DWF
CAD No.	050260
Plotted	3/26/25 2:05p
Ref. Dwg.	2024-047
Field Book	675/51
Job No.	250069
Dwg. No.	2025-022
Sheet	1 of 1

V101